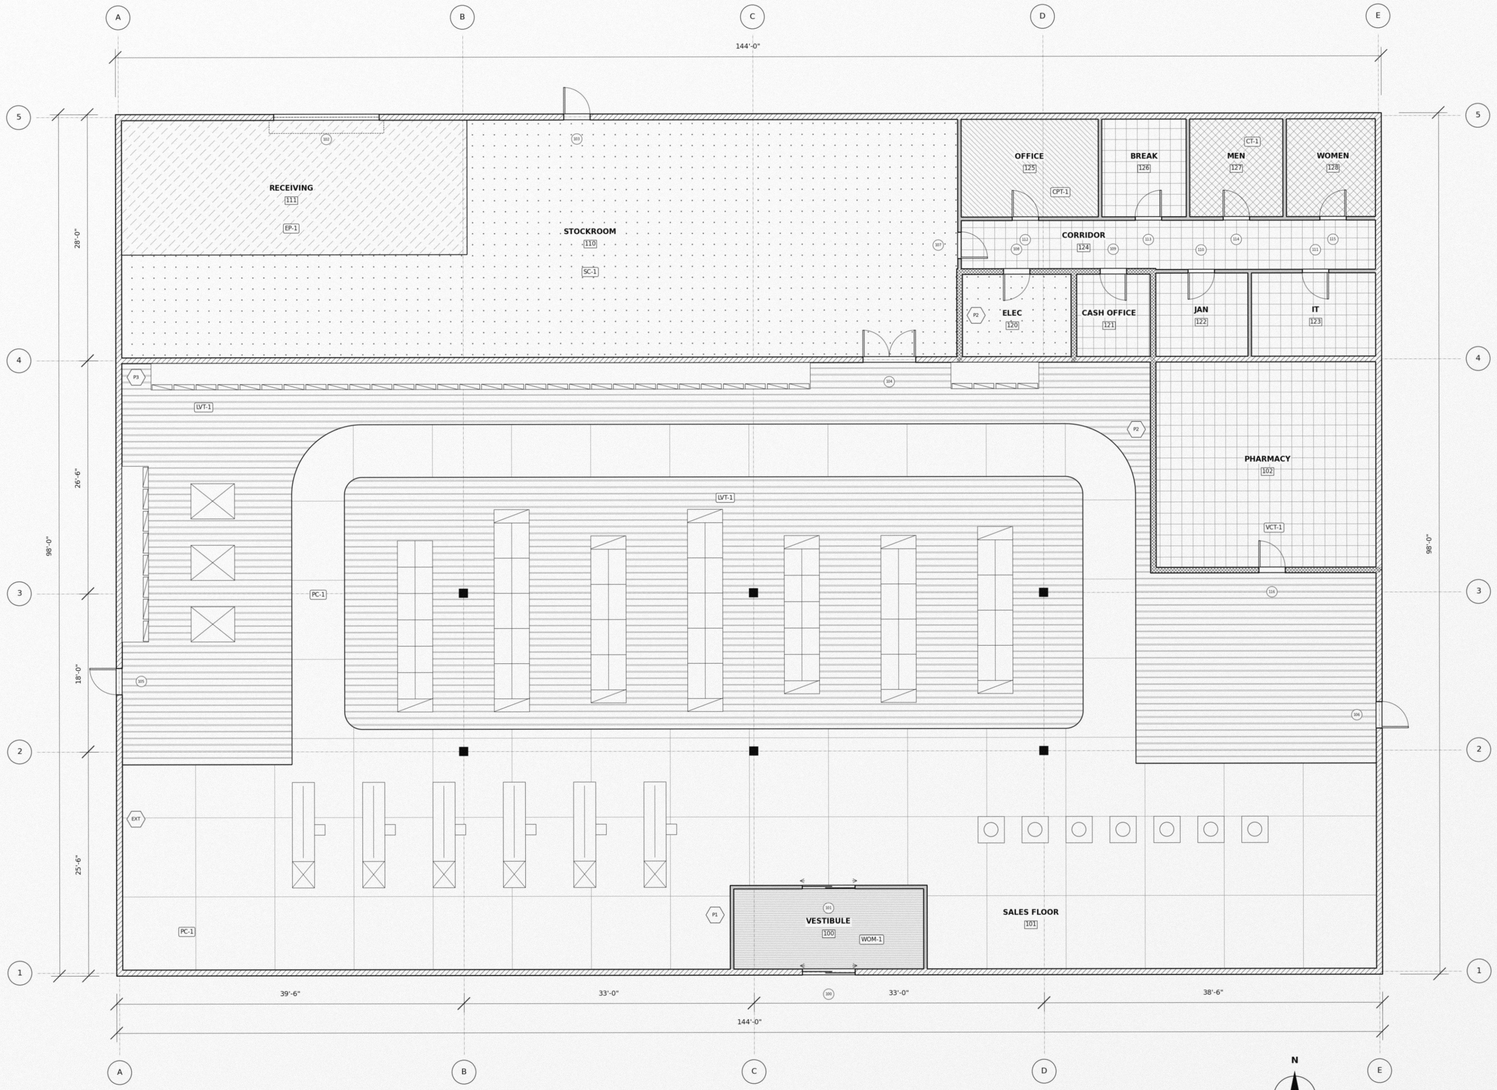


1 A101 **FLOOR PLAN - FIXTURE & FINISH**

SCALE: 1/8" = 1'-0"

LEGEND

FLOOR FINISHES

- **LVT-1** LUXURY VINYL PLANK
- **PC-1** POLISHED CONCRETE
- **SC-1** SEALED CONCRETE
- **EP-1** RESINOUS EPOXY FLOORING
- **VCT-1** VINYL COMPOSITION TILE
- **CT-1** PORCELAIN TILE
- **CPT-1** CARPET TILE
- **WOM-1** RECESSED WALK-OFF MAT

PARTITION TYPES

- EXT 8" CMU EXTERIOR WALL (BUILDING PERIMETER)
- P3 8" CMU INTERIOR PARTITION
- P2 6" MTL STUD, (1) LAYER 5/8" TYPE X GWB EA SIDE, 1 HR
- P1 3-5/8" MTL STUD, (1) LAYER 5/8" GWB EA SIDE

FIXTURES (BY OWNER, INSTALLED BY GC)

- GONDOLA RUN, 4'-0" DEEP, 3'-0" OR 4'-0" SECTIONS AS DRAWN
- GONDOLA ENDCAP
- CHECKOUT STAND
- SELF-CHECKOUT KIOSK
- REACH-IN COOLER / FREEZER DOOR
- PRODUCE DISPLAY TABLE, 5'-0" x 4'-0"
- STRUCTURAL COLUMN

GENERAL NOTES

1. DIMENSIONS ARE TO OUTSIDE FACE OF EXTERIOR WALL OR TO COLUMN GRID LINE UNLESS NOTED OTHERWISE.
2. FLOOR FINISHES EXTEND UNDER ALL FIXTURES AND EQUIPMENT.
3. FINISH TRANSITIONS OCCUR AT LINES SHOWN AND AT DOOR THRESHOLDS. RACETRACK AISLE CORNERS ARE RADIUSED.
4. FIXTURE LAYOUT PER OWNER'S PLANOGRAM, ISSUE 3.
5. VERIFY ALL CONDITIONS IN FIELD.

STILLWATER

PARTNERS

1840 W. COMMERCE ST, SUITE 300

CEDAR VALLEY MARKET

STORE #0183

CLINTON

AS-BUILT CONDITIONS

REVISIONS

1 03/14/2019 BID SET

2 05/02/2019 PERMIT SET

3 09/30/2019 AS-BUILT

DRAWN: KRL CHECKED: JMP

PROJECT NO: 19-0183

DATE: 09/30/2019

SCALE: 1/8" = 1'-0"

IF THIS BAR DOES NOT MEASURE 1"
THE DRAWING IS NOT TO SCALE

FLOOR PLAN

FIXTURE & FINISH

A101