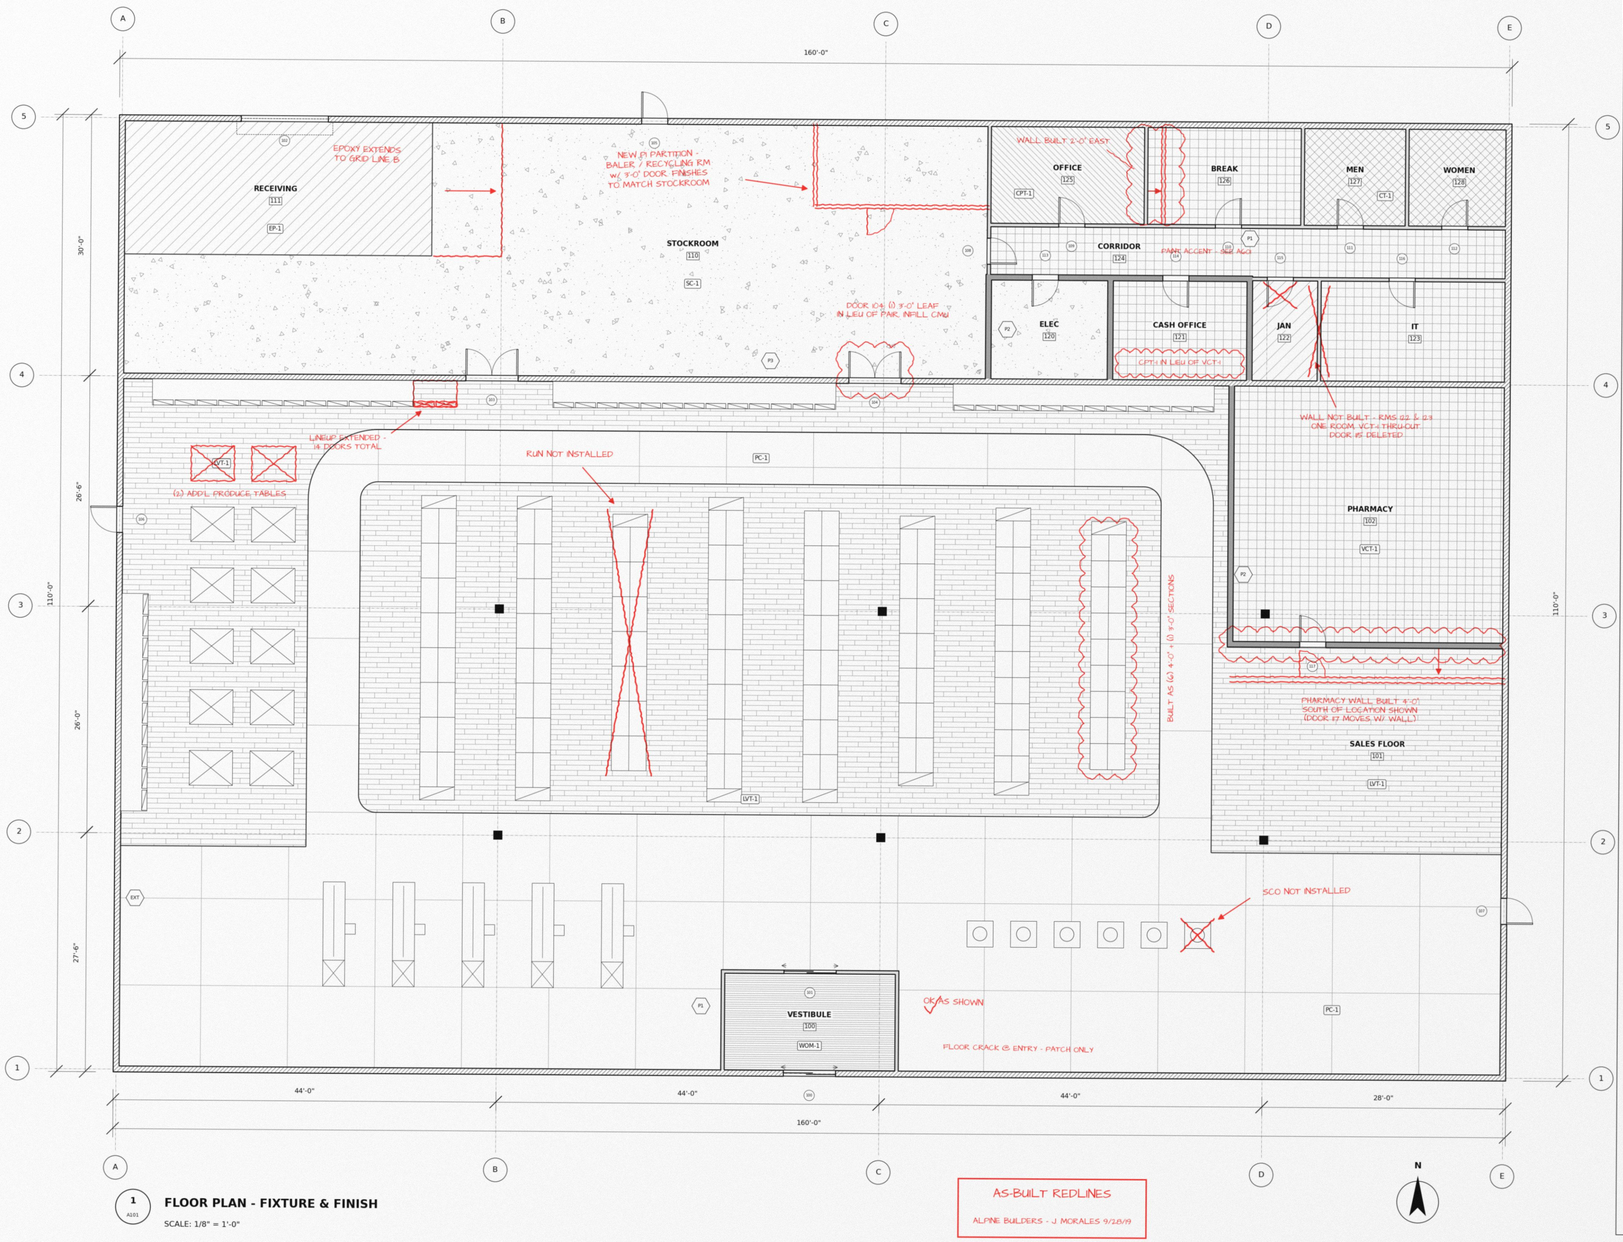


1 A101 **FLOOR PLAN - FIXTURE & FINISH**

SCALE: 1/8" = 1'-0"

AS-BUILT REDLINES

ALPINE BUILDERS - J. MORALES 9/25/19

LEGEND

FLOOR FINISHES

- **LVT-1** — LUXURY VINYL PLANK, 7" x 48"
- **PC-1** — POLISHED CONCRETE, SAWCUT JOINTS 10'-0" O.C.
- **SC-1** — SEALED CONCRETE
- **EP-1** — RESINOUS EPOXY FLOORING
- **VCT-1** — VINYL COMPOSITION TILE, 12" x 12"
- **CT-1** — PORCELAIN TILE, 9" x 9" DIAGONAL
- **CPT-1** — CARPET TILE, ASHLAR INSTALL
- **WOM-1** — RECESSED WALK-OFF MAT

PARTITION TYPES

- EXT — 8" CMU EXTERIOR WALL (BUILDING PERIMETER)
- P3 — 8" CMU INTERIOR PARTITION
- P2 — 6" MTL STUD, (1) LAYER 5/8" TYPE X GWB EA SIDE, 1 HR
- P1 — 3-5/8" MTL STUD, (1) LAYER 5/8" GWB EA SIDE

FIXTURES (BY OWNER, INSTALLED BY GC)

- GONDOLA RUN, 4'-0" DEEP, 3'-0" OR 4'-0" SECTIONS AS DRAWN
- GONDOLA ENDCAP
- CHECKOUT STAND
- SELF-CHECKOUT KIOSK
- REACH-IN COOLER / FREEZER DOOR
- PRODUCE DISPLAY TABLE, 5'-0" x 4'-0"
- STRUCTURAL COLUMN

GENERAL NOTES

1. DIMENSIONS ARE TO OUTSIDE FACE OF EXTERIOR WALL OR TO COLUMN GRID LINE UNLESS NOTED OTHERWISE.
2. FLOOR FINISHES EXTEND UNDER ALL FIXTURES AND EQUIPMENT.
3. FINISH TRANSITIONS OCCUR AT LINES SHOWN AND AT DOOR THRESHOLDS. RACETRACK AISLE CORNERS ARE RADIUSED.
4. FIXTURE LAYOUT PER OWNER'S PLANOGRAM, ISSUE 3.
5. VERIFY ALL CONDITIONS IN FIELD.

NORTHLINE

RETAIL ARCHITECTS

1840 W. COMMERCE ST, SUITE 300

CEDAR VALLEY MARKET

STORE #0417 REMODEL

2215 LAKESHORE PKWY

LAKEPORT

AS-BUILT CONDITIONS

REVISIONS

1 03/14/2019 BID SET

2 05/02/2019 PERMIT SET

3 09/30/2019 AS-BUILT

DRAWN: KRL CHECKED: JMP

PROJECT NO: 19-0417

DATE: 09/30/2019


SCALE: 1/8" = 1'-0"

IF THIS BAR DOES NOT MEASURE 1"
THE DRAWING IS NOT TO SCALE

FLOOR PLAN

FIXTURE & FINISH

A101

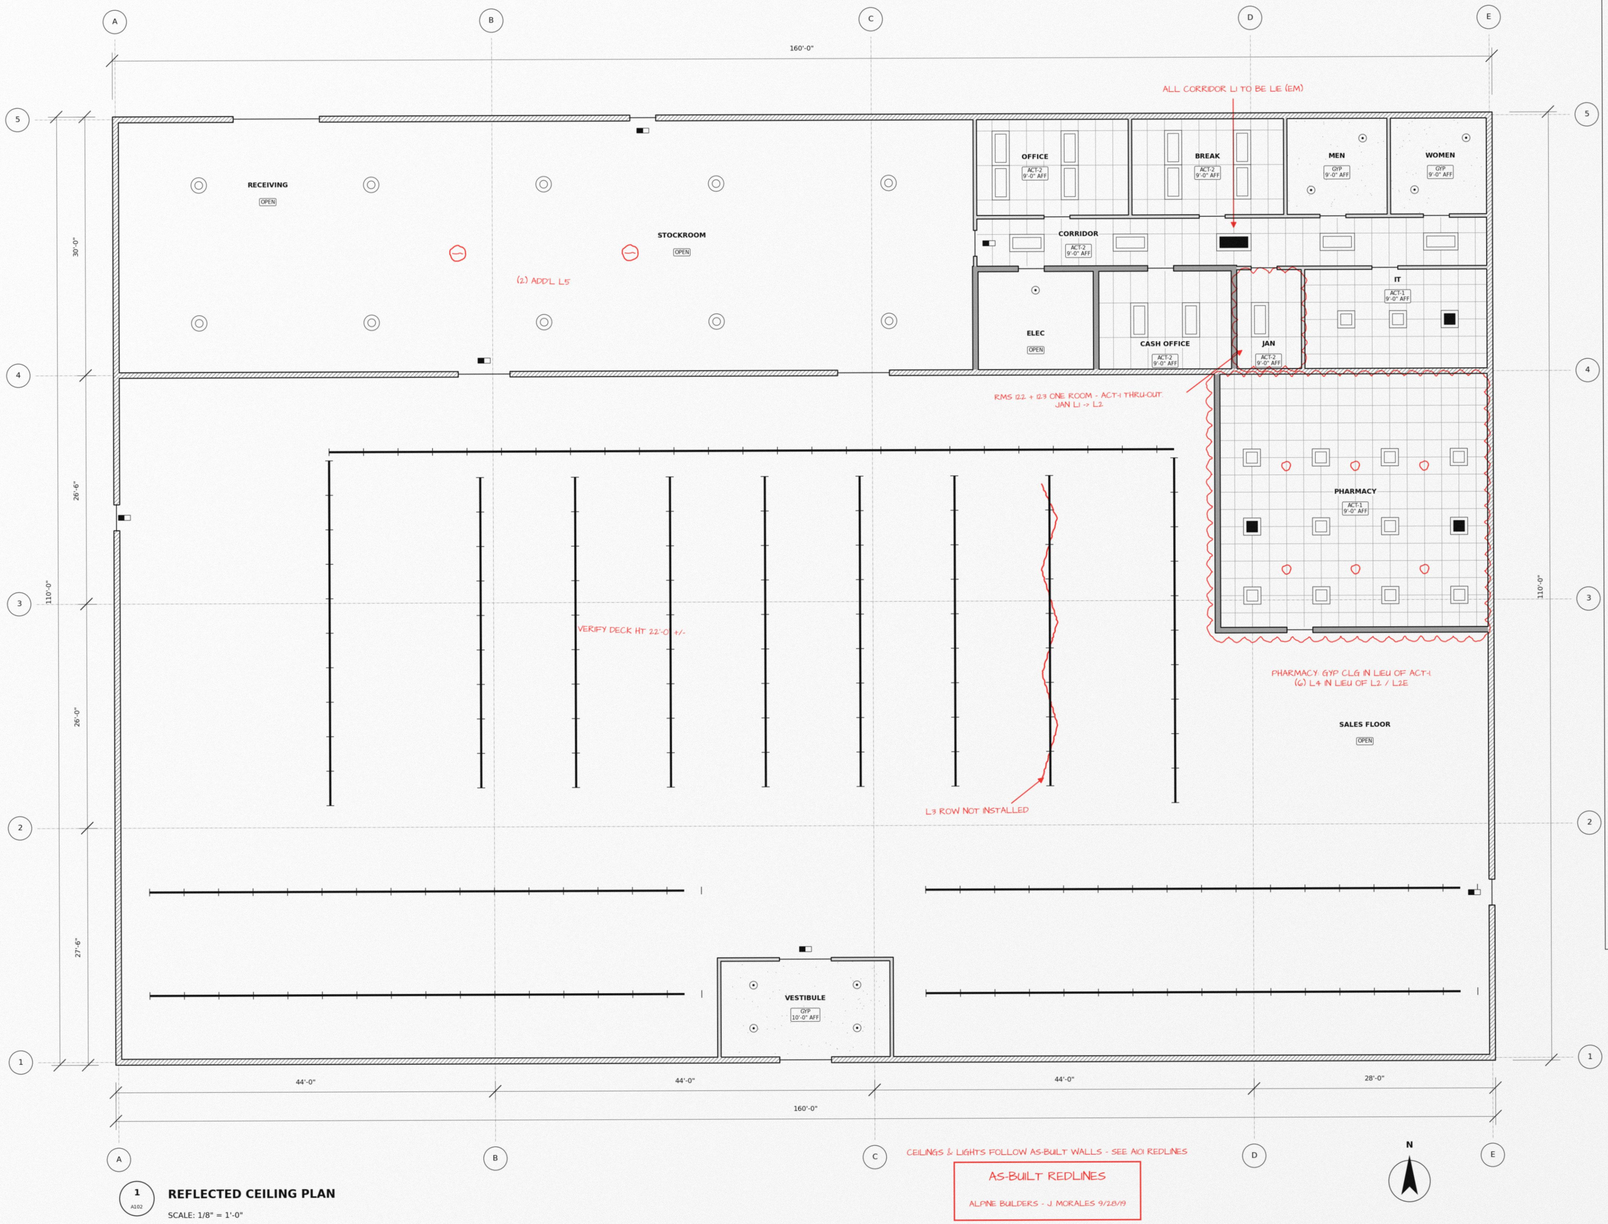

1 A102

REFLECTED CEILING PLAN

SCALE: 1/8" = 1'-0"

LEGEND

CEILING TYPES

ACT-1
2'x2' ACOUSTICAL CEILING TILE, 15/16" GRID

ACT-2
2'x4' ACOUSTICAL CEILING TILE, 15/16" GRID

GYP
5/8" GYPSUM BOARD CEILING, PAINTED

OPEN
OPEN TO STRUCTURE, PAINT EXPOSED DECK

LIGHTING (SEE FIXTURE SCHEDULE, A601)

L1
2'x4' LED TROFFER, RECESSED

L1E
L1 WITH EMERGENCY BATTERY PACK

L2
2'x2' LED TROFFER, RECESSED

L2E
L2 WITH EMERGENCY BATTERY PACK

L3
LINEAR LED PENDANT, CONTINUOUS ROW, 4'-0" MODULES

L4
6" LED DOWNLIGHT

L5
LED HIGH-BAY, 24,000 LM

X1
LED EXIT SIGN, UNIVERSAL MOUNT

GENERAL NOTES

1. CEILING HEIGHTS ARE ABOVE FINISH FLOOR (AFF).
2. L3 ROWS ARE CONTINUOUS; TICKS MARK 4'-0" MODULES.
3. COORDINATE ALL DEVICES WITH ELECTRICAL DRAWINGS.

NORTHLINE

RETAIL ARCHITECTS

1840 W. COMMERCE ST, SUITE 300

CEDAR VALLEY MARKET

STORE #0417 REMODEL

2215 LAKESHORE PKWY

LAKEPORT

AS-BUILT CONDITIONS

REVISIONS

1 03/14/2019 BID SET

2 05/02/2019 PERMIT SET

3 09/30/2019 AS-BUILT

DRAWN: KRL CHECKED: JMP

PROJECT NO: 19-0417

DATE: 09/30/2019

SCALE: 1/8" = 1'-0"

IF THIS BAR DOES NOT MEASURE 1"
THE DRAWING IS NOT TO SCALE

REFLECTED CEILING

PLAN

A102

ROOM FINISH SCHEDULE

ROOM	NAME	FLOOR	BASE	WALLS	CEILING	CLG HT
100	VESTIBULE	WOM-1	--	PT-1	GYP	10'-0"
101	SALES FLOOR	LVT-1 / PC-1	RB-1	PT-1	OPEN	--
102	PHARMACY	VCT-1	~~RB-1~~ CTB-1	PT-1	ACT-1	9'-0"
110	STOCKROOM	SC-1	--	PT-2	OPEN	--
111	RECEIVING	EP-1	--	PT-2	OPEN	--
120	ELEC	SC-1	--	PT-2	OPEN	--
121	CASH OFFICE	VCT-1	RB-1	PT-1	ACT-2	9'-0"
122	JAN	EP-1	RB-1	FRP-1	ACT-2	9'-0"
123	IT	VCT-1	RB-1	PT-1	ACT-1	9'-0"
124	CORRIDOR	VCT-1	RB-1	PT-1	ACT-2	9'-0"
125	OFFICE	CPT-1	RB-1	PT-1	ACT-2	9'-0"
126	BREAK	VCT-1	RB-1	PT-1	ACT-2	9'-0"
127	MEN	CT-1	CTB-1	CT-1 / PT-1	GYP	9'-0"
128	WOMEN	CT-1	CTB-1	CT-1 / PT-1	GYP	9'-0"

BASE: RB-1 = 4" RUBBER COVE BASE. CTB-1 = 6" PORCELAIN COVE BASE TO MATCH CT-1.

BASE IS INSTALLED AT ALL WALLS OF ROOMS SCHEDULED TO RECEIVE BASE.

WALLS: PT-1 EGGSHELL PAINT. PT-2 EPOXY PAINT. FRP-1 FIBERGLASS PANEL, FULL HEIGHT.

FLOOR FINISH CODES PER LEGEND, SHEET A101.

LIGHT FIXTURE SCHEDULE

TYPE	DESCRIPTION	MOUNTING	SOURCE
L1	2'x4' LED TROFFER, RECESSED	RECESSED	LED
L1E	L1 WITH EMERGENCY BATTERY PACK	RECESSED	LED
L2	2'x2' LED TROFFER, RECESSED	RECESSED	LED
L2E	L2 WITH EMERGENCY BATTERY PACK	RECESSED	LED
L3	LINEAR LED PENDANT, CONTINUOUS ROW, 4'-0" MODULES	PENDANT	LED
L4	6" LED DOWNLIGHT	RECESSED	LED
L5	LED HIGH-BAY, 24,000 LM	PENDANT	LED
X1	LED EXIT SIGN, UNIVERSAL MOUNT	WALL / CEILING	LED

AS-BUILT REDLINES

ALPINE BUILDERS - J. MORALES 9/25/19

NORTHLINE

RETAIL ARCHITECTS

1840 W. COMMERCE ST, SUITE 300

CEDAR VALLEY MARKET

STORE #0417 REMODEL

2215 LAKESHORE PKWY

LAKEPORT

AS-BUILT CONDITIONS

REVISIONS

1 03/14/2019 BID SET

2 05/02/2019 PERMIT SET

3 09/30/2019 AS-BUILT

DRAWN: KRL CHECKED: JMP

PROJECT NO: 19-0417

DATE: 09/30/2019

SCALE: NONE

SCHEDULES

FINISH & LIGHTING

A601